



CITY OF TAMPA

Pam Iorio, Mayor

CONTRACT ADMINISTRATION DEPARTMENT

David L. Vaughn, AIA, Director

ADDENDUM NO. 2 DATE: November 20, 2007

Project: Cypress Point Park – Shoreline Stabilization PW6737
Contract: 7-C-10

Bidders on the above referenced project are hereby notified that the following addendum is made to the Contract Documents. BIDS TO BE SUBMITTED SHALL CONFORM TO THIS NOTICE.

- Item 1: Specifications, Insurance Requirements, Required Insurance, **procure and maintain USLH coverage for applicable portions of the work (water ward) in addition to other required coverage.**
- Item 2: Specifications, Insurance Requirements, Builders Risk Insurance/Installation Floater, **procure and maintain 30% of the contract amount as required.**
- Item 3: Specifications, Minority Business Requirements, Page No. W/MBE-5, **replace with Form No. PMT1 (rev. 09/12/07), Page No. W/MBE-5 attached to this Addendum.**
- Item 4: Specifications, Proposal, Page No's, P-2a and P-2c, **replace with Form No's. MBD-10 (rev. 09/12/07) and MBD-20 (rev. 09/12/07) attached to this Addendum.**
- Item 5: Specifications, Supplementary General Provisions, Item 2.7 – Section 14 Miscellaneous, paragraph G-14.11 Engineer's Field Office, **DELETE in its entirety.**
- Item 6: **If required, City of Tampa permit(s) will be fee-waived.**
- Item 7: **The entire Park will NOT be closed to the general public during this project; however, the beach will be closed and City of Tampa Parks & Recreation personnel will install "Beach Closed" signs at the 3 designated entry points to the beach. Any other protections deemed necessary for public safety (temporary fencing, etc.) shall be provided by the Contractor.**
- Item 8: **The Contactor shall be responsible for preparation of the certified as-built drawings for submittal to the City and Environmental Regulatory agencies. Please note that certified as-builts are required of final grades prior to planting (reference FDEP/ERP Mitigation Conditions, Conditions 41, page 14 and 15 of 20).**
- Item 9: **The Contactor shall be responsible for maintenance of State water quality standards pursuant to the permit conditions. The Contractor shall be responsible for preparation of the Stormwater Pollution Prevention Plan (SWPPP) which is required to accompany the NPDES (MS4) Permit Application and Notice of Intent (reference Sheet 3 of 7 of the Construction Plans). The FDEP will not require specific sampling protocol pursuant to the ERP.**

306 E. Jackson Street, 4N • Tampa, Florida 33602 • (813) 274-8456 • FAX: (813) 274-8080


www.tampagov.net

- Item 10: The Tampa Port Authority (TPA), FDEP and the FFWCC were all contacted about the navigation marker. These agencies agreed to accept the navigation marker criteria from the USCG. The USCG does not require a lighted marker at this location.
- Item 11: The USCG required warning markers are to be placed as shown in the plans. The Contractor is responsible for accurately showing their location on the signed and sealed certified as-built surveys for the project to be prepared by the Contractor. The Contractor shall also show the GPS location (NAV83 datum) of the warning markers.
- Item 12: All manatee conditions and signage are required as noted in the various permits.
- Item 13: The Contractor shall be responsible for preparation and submittal to the City of the "Time Zero" post planting report (reference FDEP/ERP Mitigation Condition 38, page 14 of 20) and the preparation of the signed and sealed as-built surveys (reference FDEP/ERP Mitigation Condition 41, page 14 and 15 of 20).
- Item 14: Strippings from the stockpiled material may be left on-site at the location of the donor mound.
- Item 15: Area left after removing material from donor mound site does not have to be sodded; however, other areas disturbed by construction activities, including staging area, etc., shall be restored per note on Sheet 3 of 7.
- Item 16: A truck count measurement of excavated material, including stockpiled material and fill material from the on-site sources and off-site sources will be performed by the City.
- Item 17: Prior to submission, the City shall review any Contractor-prepared agency correspondence. The Contractor shall perform all required USACE, FDEP and TPA permit notifications in writing.
- Item 18: Drawings, Sheet 3 of 7, Construction Access and Staging Areas Plan, clarification that note "LOCATION OF PROPOSED PICNIC SHELTERS" pertains to future shelters, beyond the scope of this project.
- Item 19: Drawings, Sheet 5 of 7, North Groin Schedule, Station 141 to 168, change WALL TYPE from 950 to 650.
- Item 20: Drawings, Sheet 5 of 7, South Groin Schedule, Station 153 to 185, change WALL TYPE from 950 to 650.
- Item 21: Drawings, Sheet 6 of 7, Section 9+00, Section 11+00 and Section 12+00, utilize Drawing No's, 6.1 and 6.2 attached to this Addendum for scaleable fill profiles for these sections.



This addendum shall be included in and attached to the inside cover of the Contract Documents by and upon which bids are submitted.


All other provisions of the Contract Documents and Specifications not in conflict with this Addendum shall remain in full force and effect.

Questions may be directed to Jim Greiner, P.E.; Telephone (813) 274-8598, fax (813) 274-8080, or e-mail Jim.Greiner@tampagov.net.



Jim Greiner, P.E., Contract Manager
Contract Administration Department

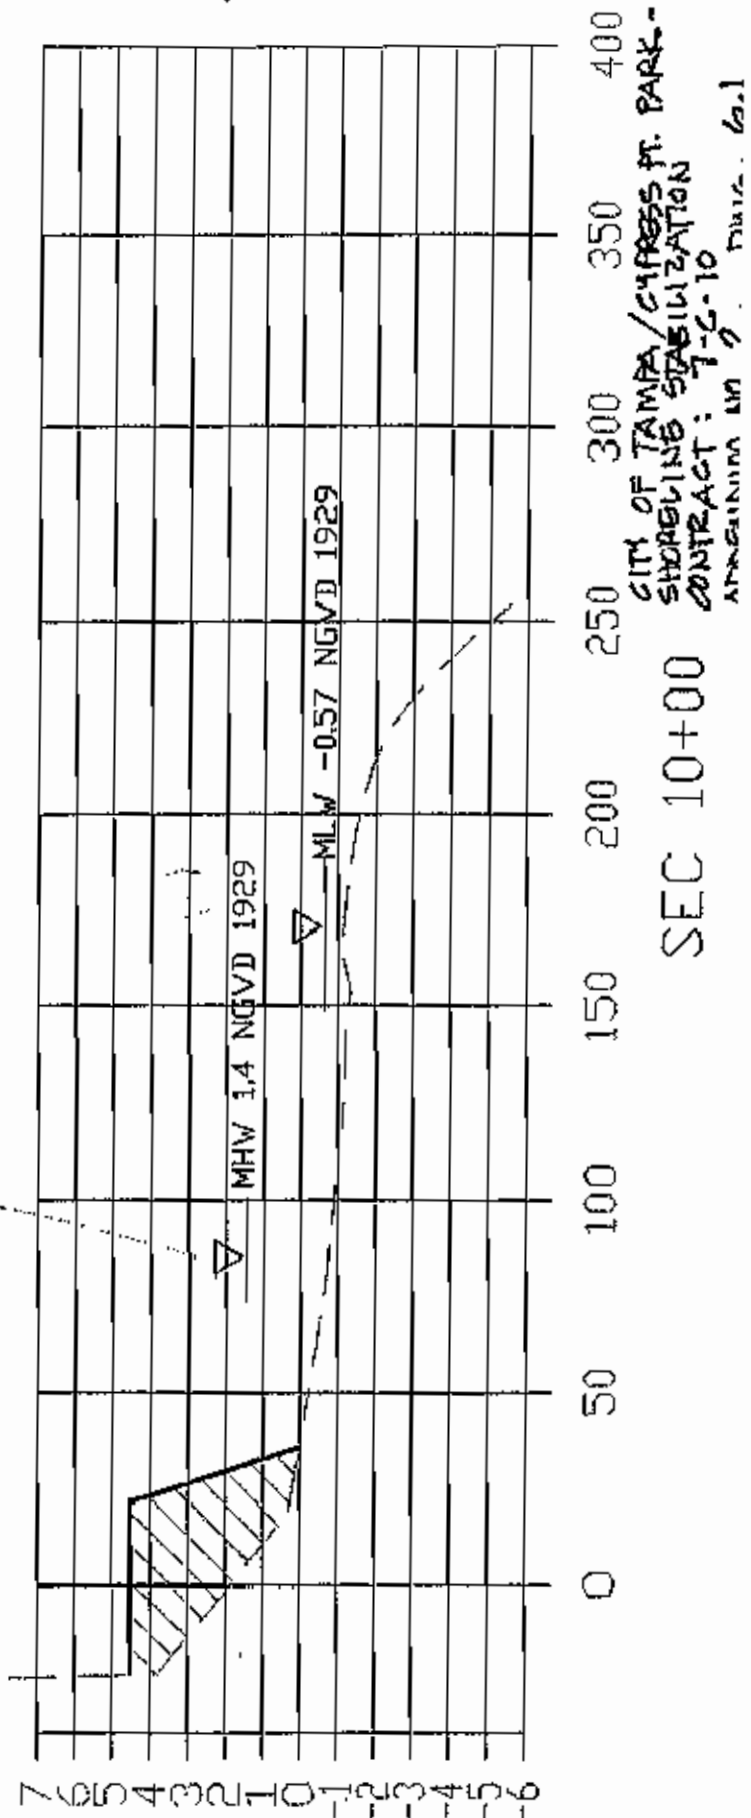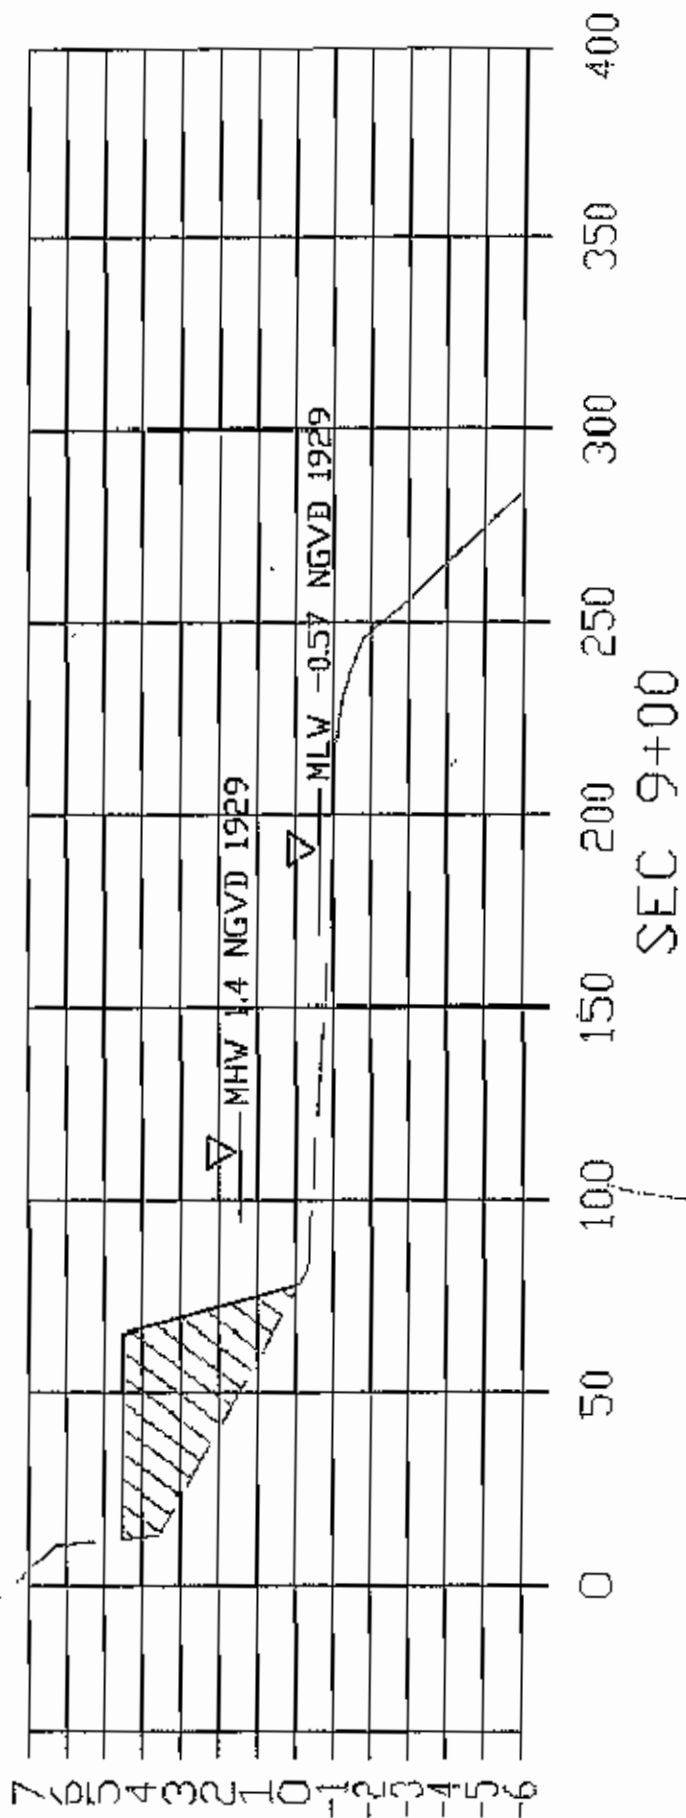

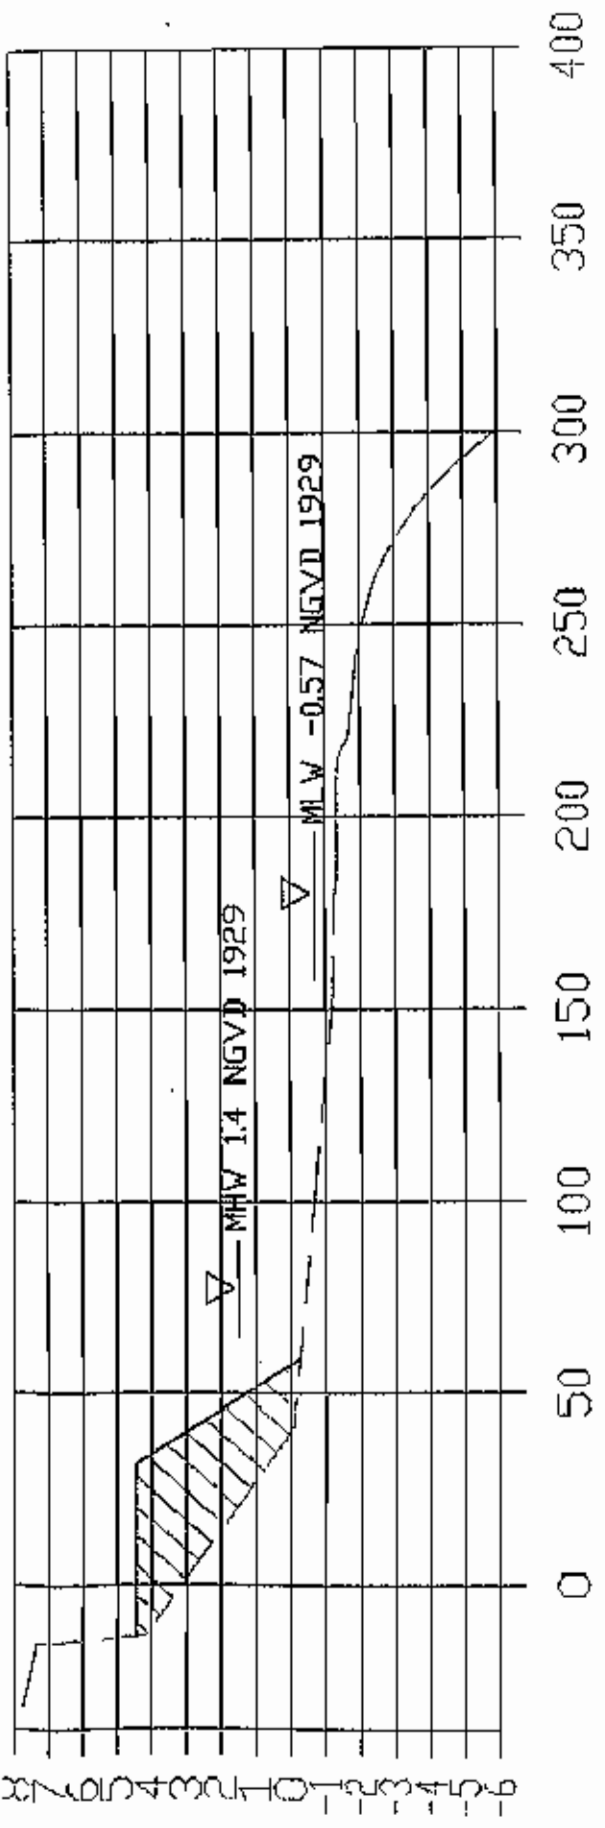

SEC 11+00

