



CITY OF TAMPA

Jane Castor, Mayor

CONTRACT ADMINISTRATION DEPARTMENT

Michael W. Chucran, Director

ADDENDUM 1

DATE: June 21, 2019

Contract 19-C-00034; Saint Isabel Pumping Station Rehabilitation

Bidders on the above referenced project are hereby notified that the following addendum is made to the Contract Documents. BIDS TO BE SUBMITTED SHALL CONFORM TO THIS NOTICE.

Item 1: Add the following Bypassing Note to Sheet 3 of the Plans:

B-8. Although not shown on the plans, the contractor shall install a minimum of three 1.5-inch (minimum) diameter electrical conduits, buried a minimum of 24-inches underground for bypass pumping float switches and high water-level alarm, from the bypassing manhole in the street to a point 5-feet (minimum) north of paved roadway where the conduits shall turn up and transition to above ground conduits. Contractor shall cap conduits 6-inches below ground level after construction and indicate locations of all underground conduits in the as-built red-line drawings for record.

Item 2: Replace Plan Sheet 7 of the with the attached revised Sheet 7.


Item 3: Attached is a copy of the pre-bid meeting sign in sheet.

All other provisions of the Contract Documents and Specifications not in conflict with this Addendum shall remain in full force and effect. Questions are to be e-mailed to ContractAdministration@tampagov.net.

Jim Greiner

Jim Greiner, P.E., Contract Management Supervisor


User: sst13 Drawing Name: K:\WasteWater Projects\St Isabel PS Rehabilitation\Drafting\DWG\ST ISABEL PS.dwg Layout - Jun 19, 2019 - 9:27am

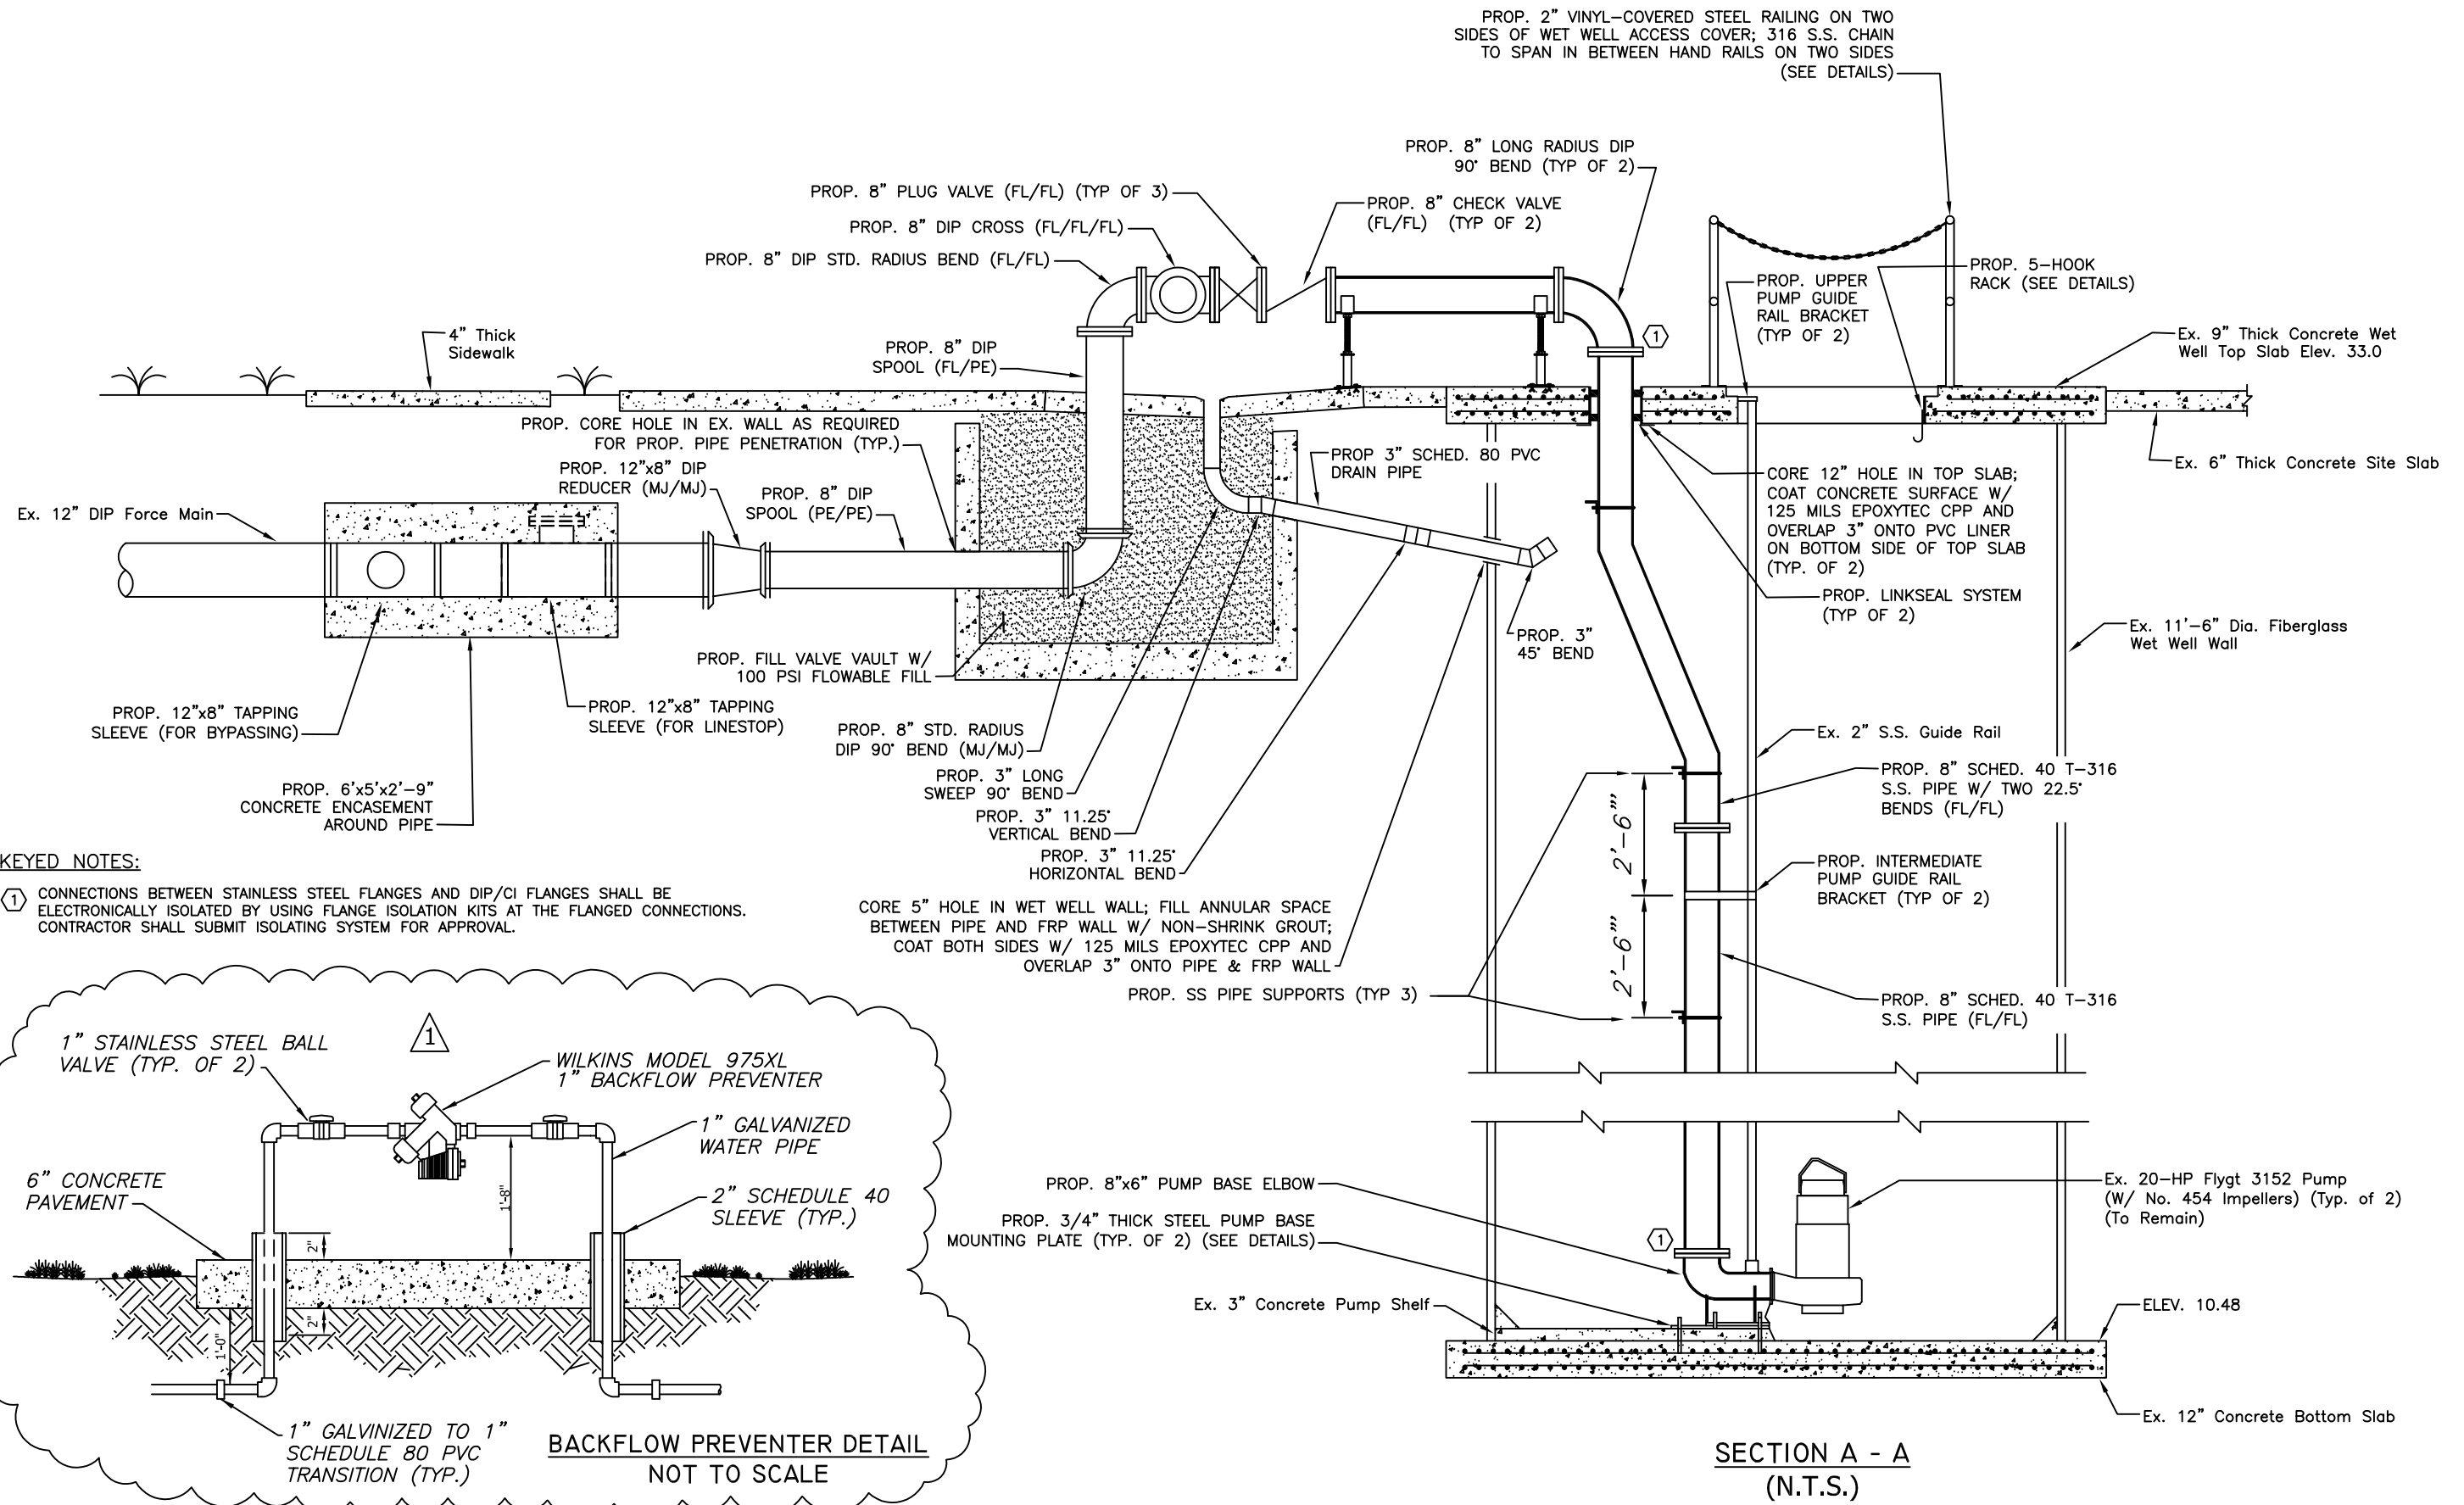

KEYED NOTES:

1 CONNECTIONS BETWEEN STAINLESS STEEL FLANGES AND DIP/CI FLANGES SHALL BE ELECTRONICALLY ISOLATED BY USING FLANGE ISOLATION KITS AT THE FLANGED CONNECTIONS. CONTRACTOR SHALL SUBMIT ISOLATING SYSTEM FOR APPROVAL.

CORE 5" HOLE IN WET WELL WALL; FILL ANNULAR SPACE BETWEEN PIPE AND FRP WALL W/ NON-SHRINK GROUT; COAT BOTH SIDES W/ 125 MILS EPOXYTEC CPP AND OVERLAP 3" ONTO PIPE & FRP WALL

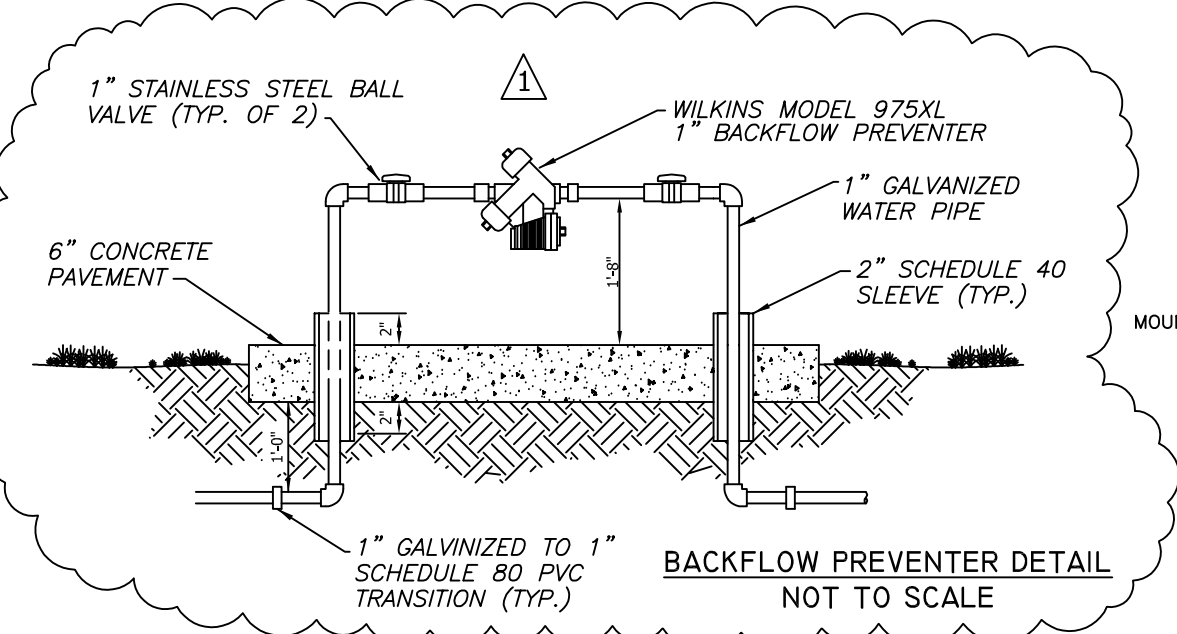

**SECTION A - A
(N.T.S.)**

No.	DATE	REVISIONS	DES:	JH	<p align="center">CITY of TAMPA WASTEWATER DEPARTMENT</p>	<p align="center">SAINT ISABEL PUMPING STATION REHABILITATION</p> <p align="center">PROPOSED PROFILE</p>	<p align="center">SHEET 7</p>
3			DRN:	MRL/JHJ			
2			CKD:				
1	6/18/19	Added Backflow Preventer Detail	DATE:				

B105-091

E-Mail to Register as a Plan Holder and E-Mail All Questions to: ContractAdministration@tampagov.net

Sign-In Sheet Please Print

City of Tampa, Contract Administration Department

	Name	Organization	E-Mail OR Phone
1	Jody Gray	Tampa Contract Administration Dept.	Jody.Gray@tampagov.net
2	CARMEN RODRIGUEZ	COT-CAD	813 274 8180
3	CHARLES KINDER	Commercial Interiors	charliecommintwk@aol.com
4	Steve vonbortel	MWI Pump	Steven.v@mwipumps.com
5	Nathan Briones	KAT Construction	ptoolkey@kating.us
6	Michael Hampton	COT-CAD	Michael.Hampton@Tampagov.net
7	Marisela Linares	Quice Construction Solutions	quices@outlook.com
8	Javier Linares	JL Welding and Fabrication	jlwelding.fab@gmail.com
9	JOHNNY GRANBER	MORENO IND.	JOHNNY @ MORENOIND.COM
10	Mark Johnson	COT/CAD	Mark.Johnson@Tampagov.net
11	Roman Karchak	COT/WWD	Roman.Karchak@tampagov.net
12	Vin Hennessy	COT/WWD	vin.hennessy@tampagov.net
13			
14			
